

© COPYRIGHT 1977 BY AMP INCORPORATED, HARRISBURG, PA.
ALL INTERNATIONAL RIGHTS RESERVED. AMP INCORPORATED PRODUCTS
COVERED BY U. S. AND FOREIGN PATENTS AND/OR PATENTS PENDING.

3 207438-2 1. AS SHOWN.

207438-3

1. SAME AS -2 EXCEPT:
2. LOOSE PIECE

207438-5

1. SAME AS -2 EXCEPT:
2. LOOSE PIECE


REVISIONS				
P.	F.	DATE	DESCRIPTION	APPROVED
1	✓	12-87	OB SOLEATED -57 ECU R-2613	RG AT
2	✓	5-3-93	REV PER EC 0020-289-93	RK

~~OB SOLEATED~~ EXCEPT:
1. SAME AS -2 EXCEPT:
2. LOOSE PIECE

~~OB SOLEATED~~ EXCEPT:
1. SAME AS -2 EXCEPT:
2. LOOSE PIECE

3 -8 1. SAME AS -2 EXCEPT:
2. GOLD FLASH / ALL PLATED.
-9 1. SAME AS -8 EXCEPT:
2. LOOSE PIECE.

POINT OF PLATING
THICKNESS MEASURE-
MENT (SIDE OPPOSITE
SEAM)

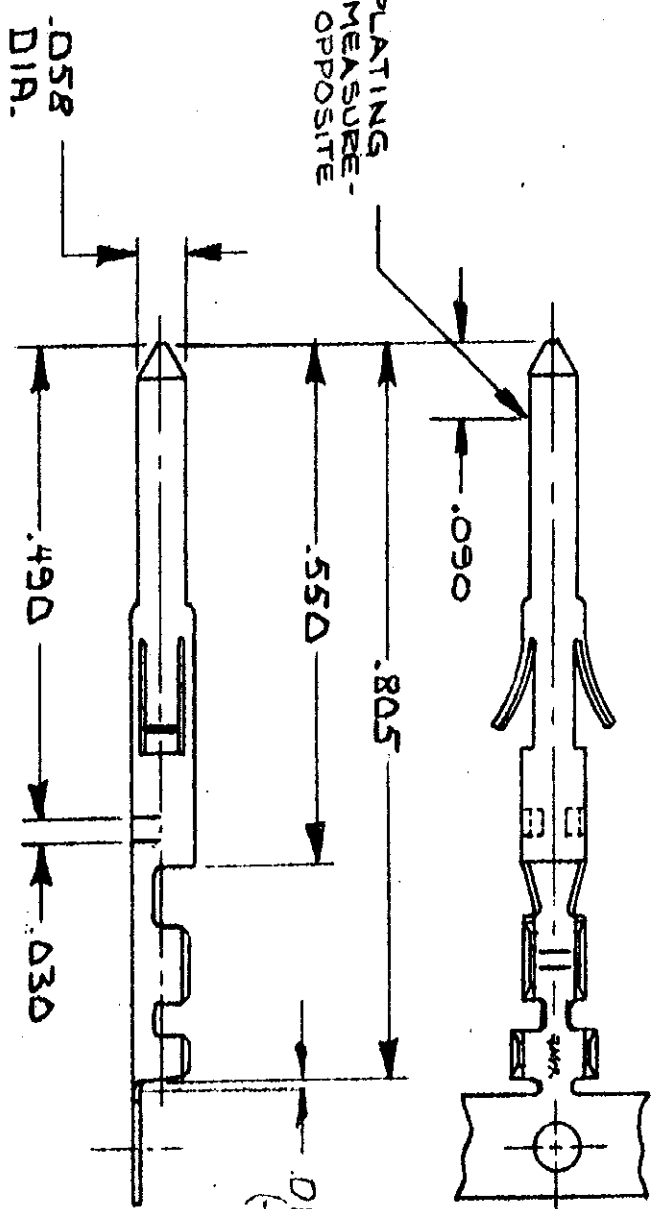

1. WIRE RANGE = 22-28.
2. INSULATION RANGE = .036-.054 DIA.
3. REVERSE REELED FOR MINI-APPLICATOR.

UNLESS OTHERWISE
SPECIFIED DIMENSIONS
ARE IN INCHES.
TOLERANCES ON:
DECIMALS ± .005
ANGLES ± .1°

MATERIAL

BRASS

FINISH

PLATE

CONTRACT NO

DR 3-2-77

CHK 9. WICK

APPROV 3/3/77

APPROV 3/3/77

DESIGN APPROV

OTHER APPROV

NAME

CONTACT, PIN

SIZE CODE IDENT NO DRAWING NO

B 00779 207438

SCALE 1:1 SHEET 1 OF 1

PART NO

AMP INCORPORATED
HARRISBURG, PA.