
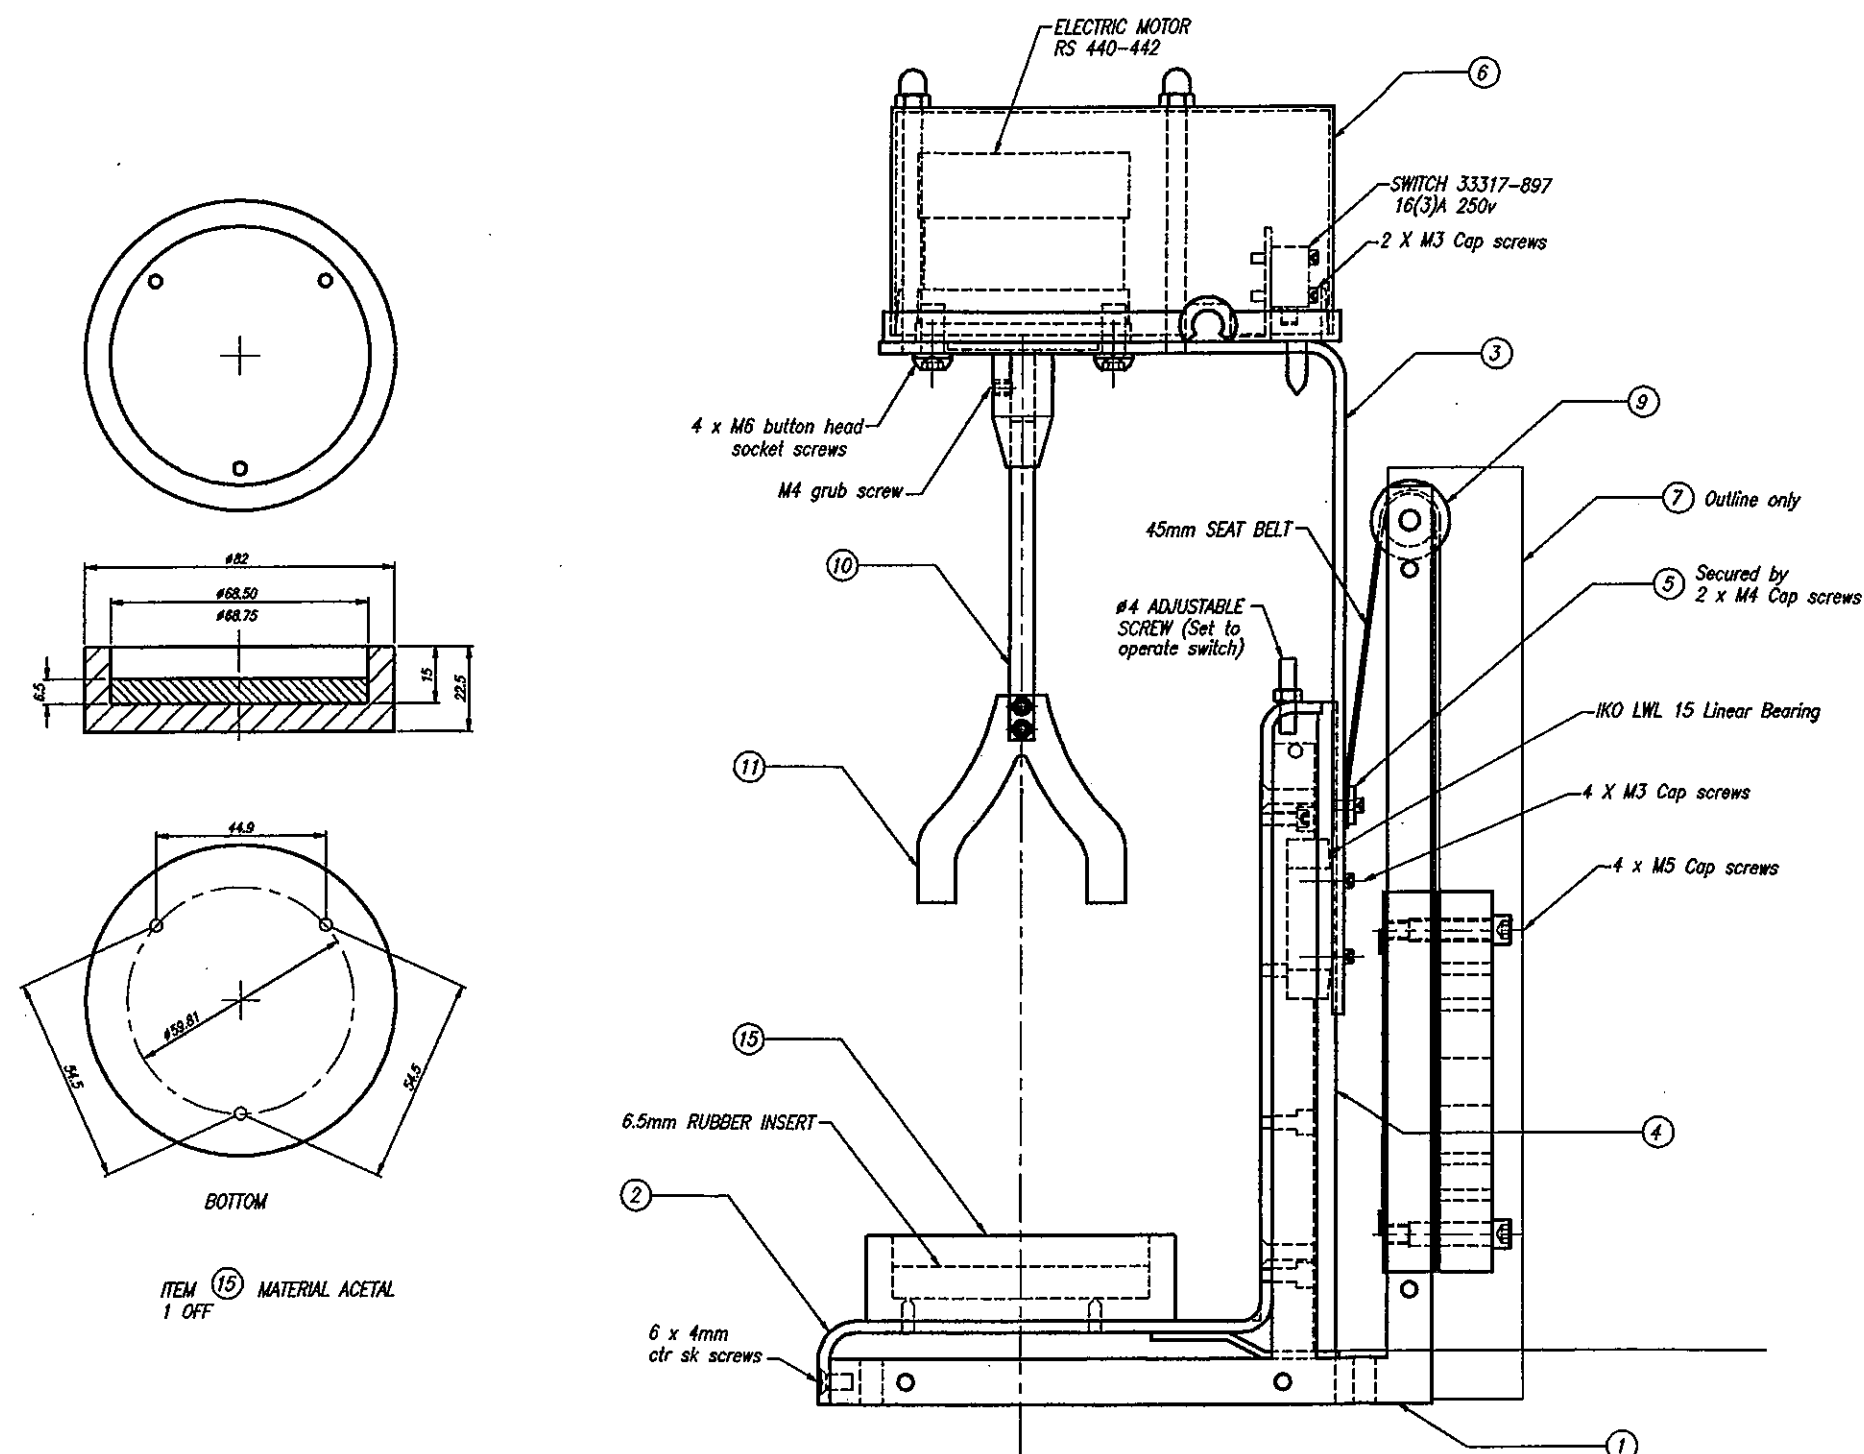


DRAWING No	2-432	A
------------	-------	---

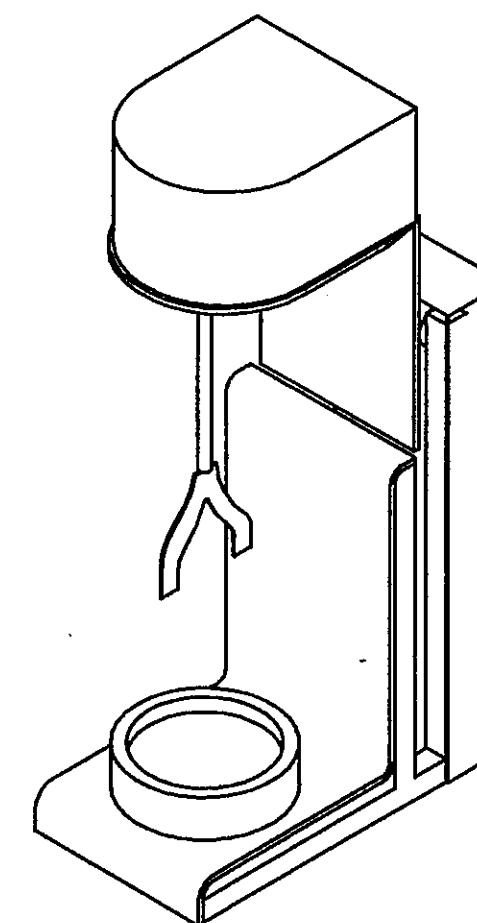

NOTE NEAR SIDE COVER NOT SHOWN AND OUTLINE ONLY OF BACK COVER SHOWN

1	As built/construction	NRL	11-
0	Concept/development	IWH	
No	REVISION DETAILS	BY	DATE
Design	IWH	RL	
Dress	GD	NRL	11-4-98
Approved			

JOB TITLE

Milk powder mixer


*Item numbers
3, 5, 6, 7, 8 & 9
details*

DRAWN SCALE 1:2

PROJECT No						
REVISION	0	1	2	3	4	5
SHEET	3	OF	3			

© Copyright NEW ZEALAND SMIRY RESEARCH INSTITUTE.
May not be copied without written consent.

DRAWING No. 2-432

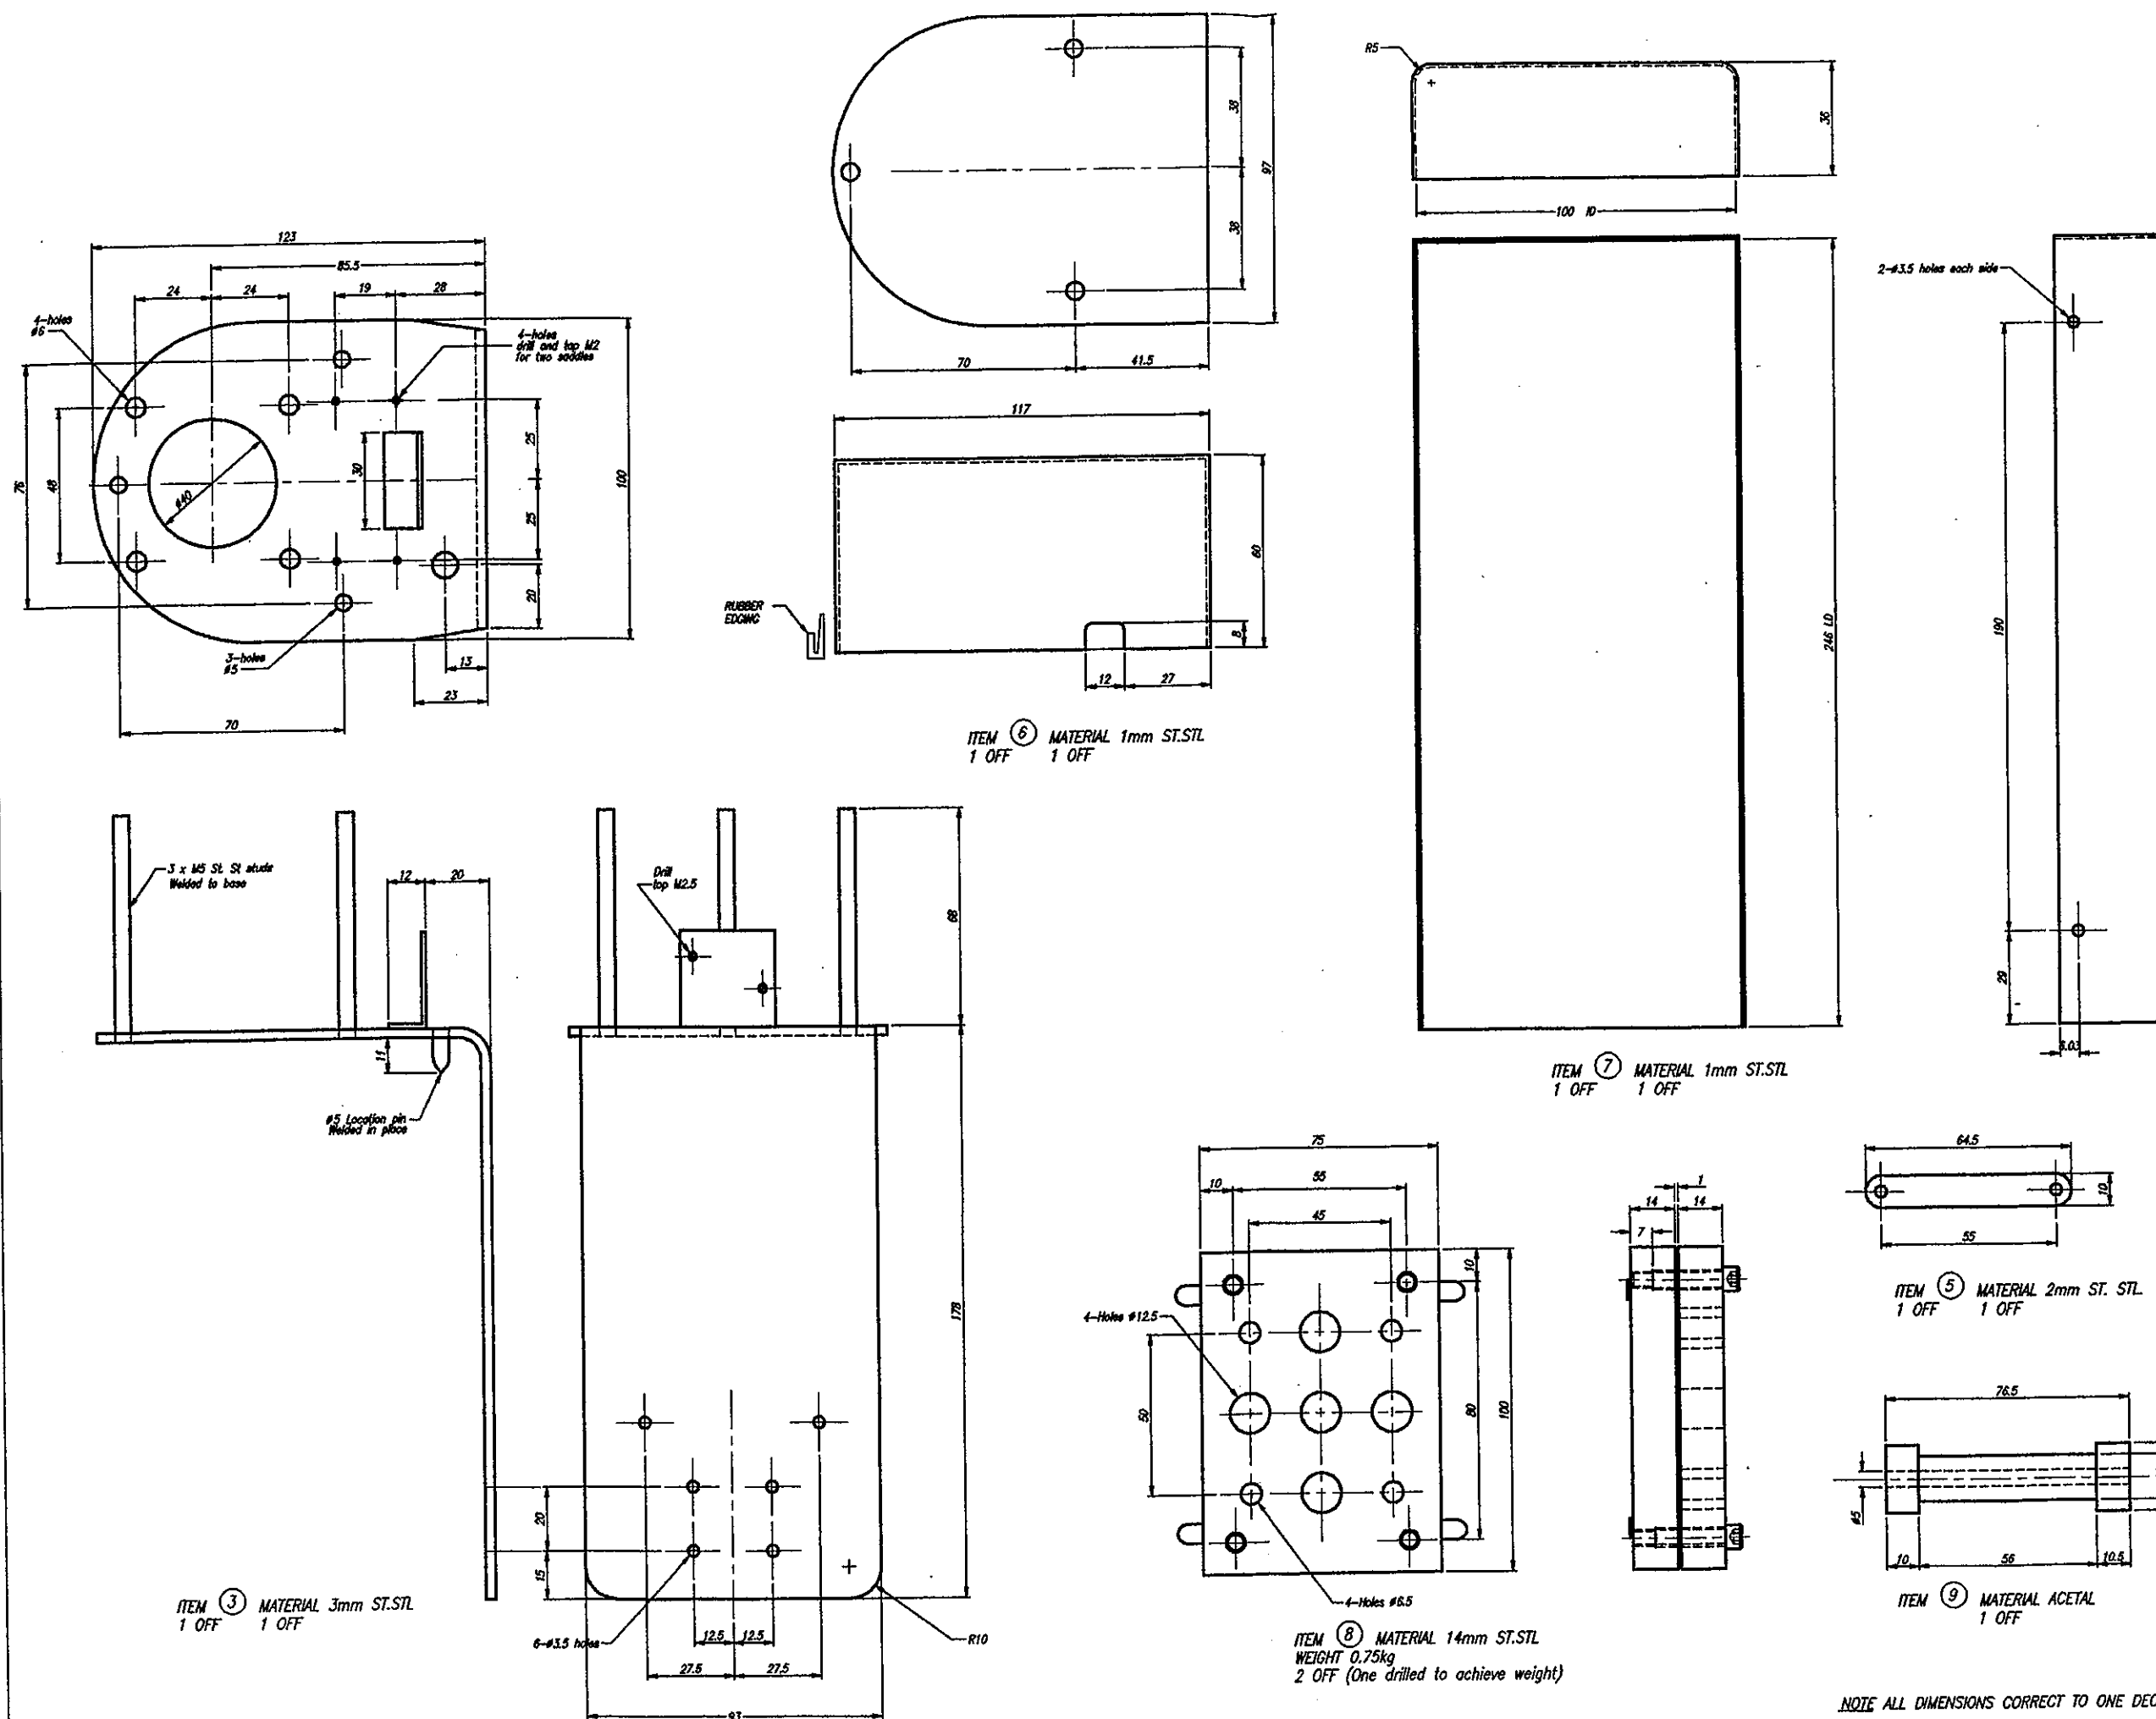

NOTE ALL DIMENSIONS CORRECT TO ONE DECIMAL PLACE

All stainless steel components to have a
Hot polished finish

1	As built/construction	NRL	11-4
0	Concept/development	VWH	

No	REVISION DETAILS	BY	DATE
----	------------------	----	------

Design	By	Checked	Date
Drawn	GD	NRL	11-4-98
Approved			

JOB TITLE

Milk powder mixer

DRAWING TITLE

Item numbers
1, 2, 4, 10 & 11
details








DRAWN SCALE 1:2



PROJECT No

REVISION	0	1	2	3	4	5	6
SHEET	2	OF	3				

© Copyright NEW ZEALAND DAIRY RESEARCH INSTITUTE
May not be copied without written consent

DRAWING No 2-432 A3

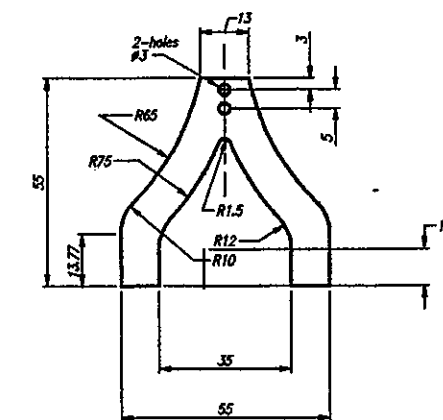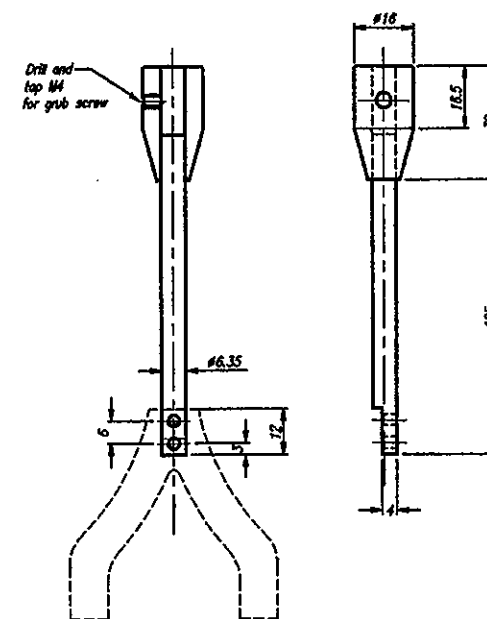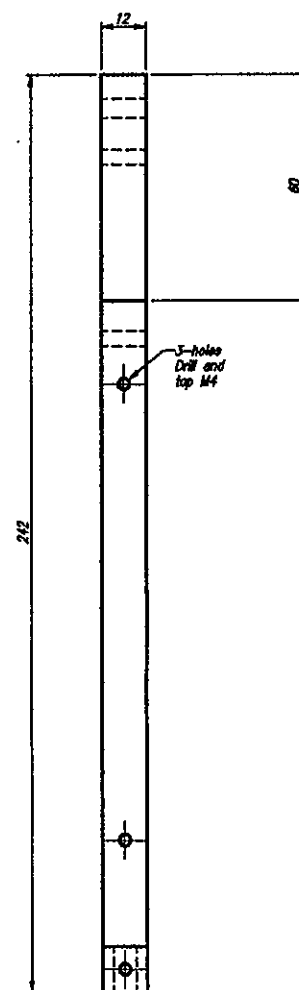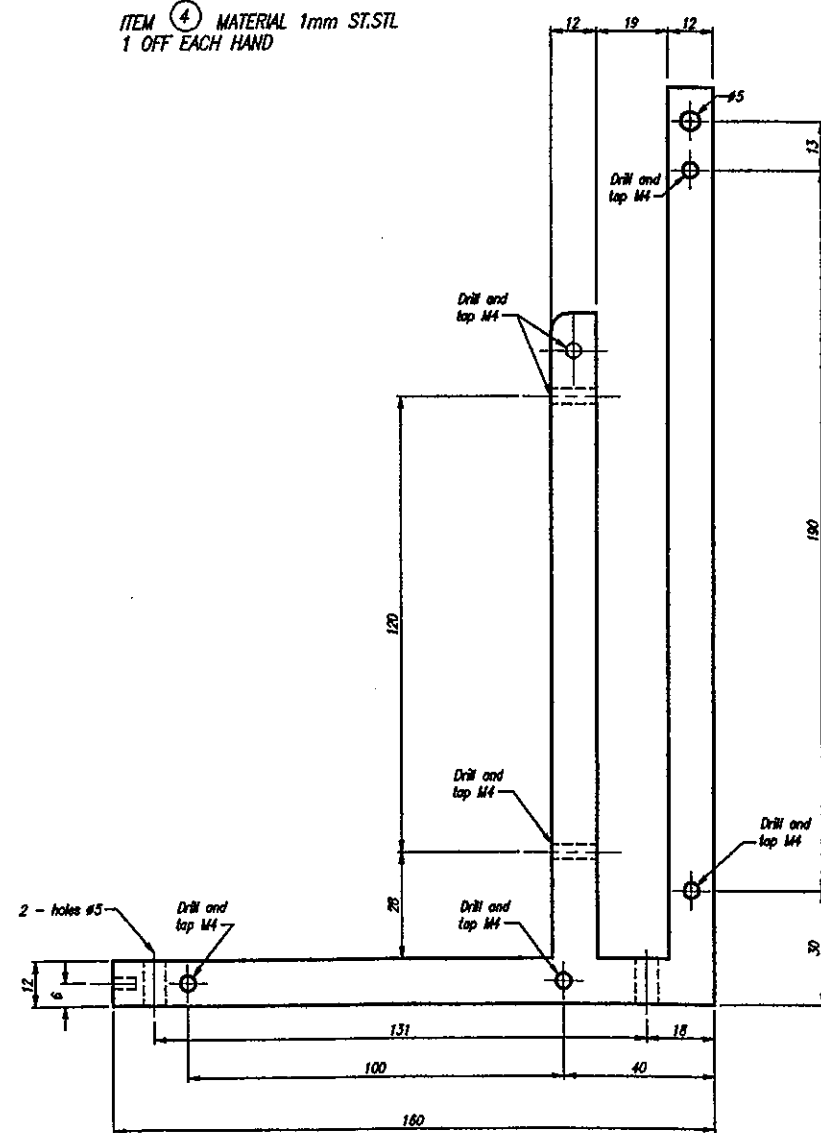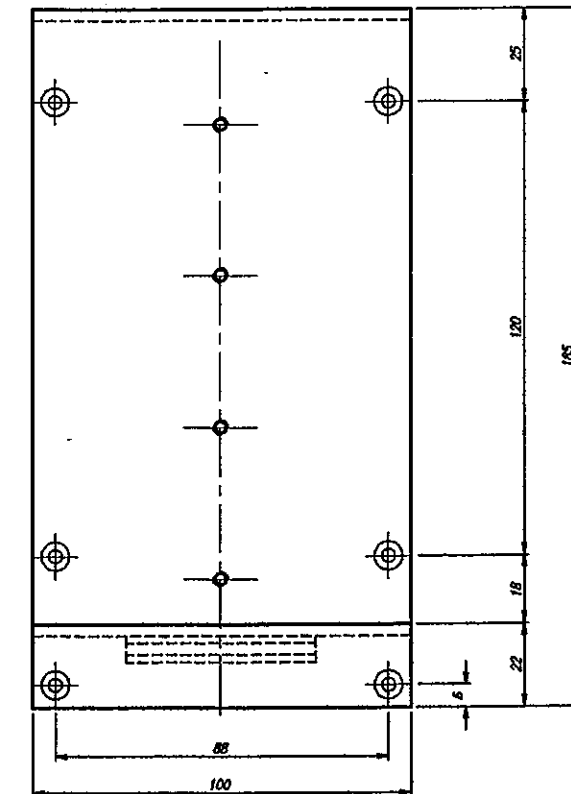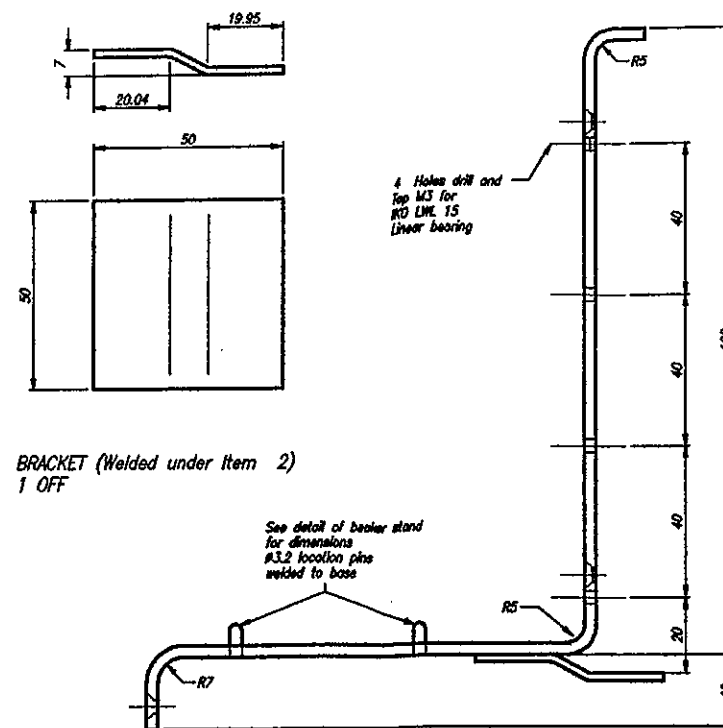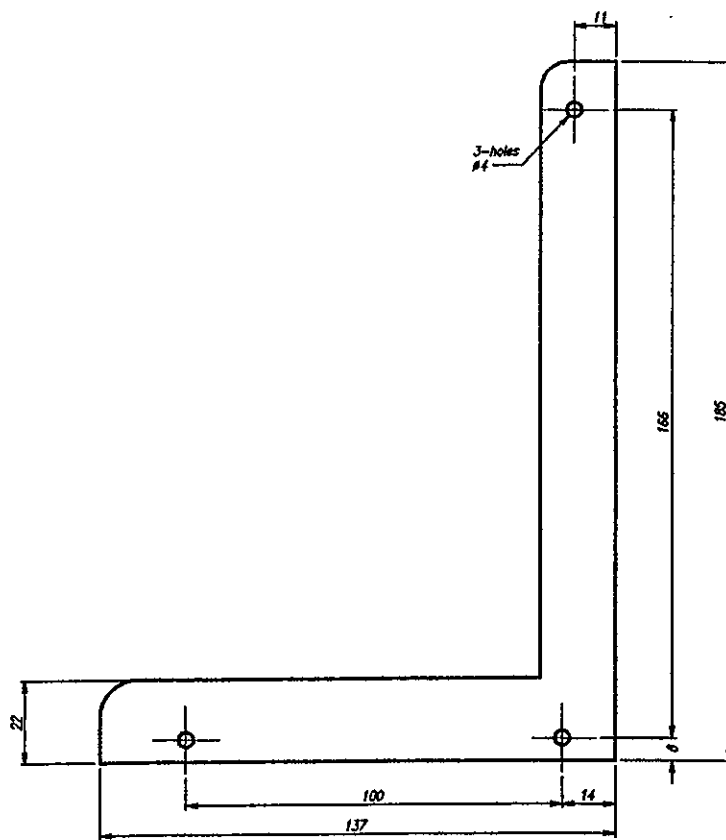

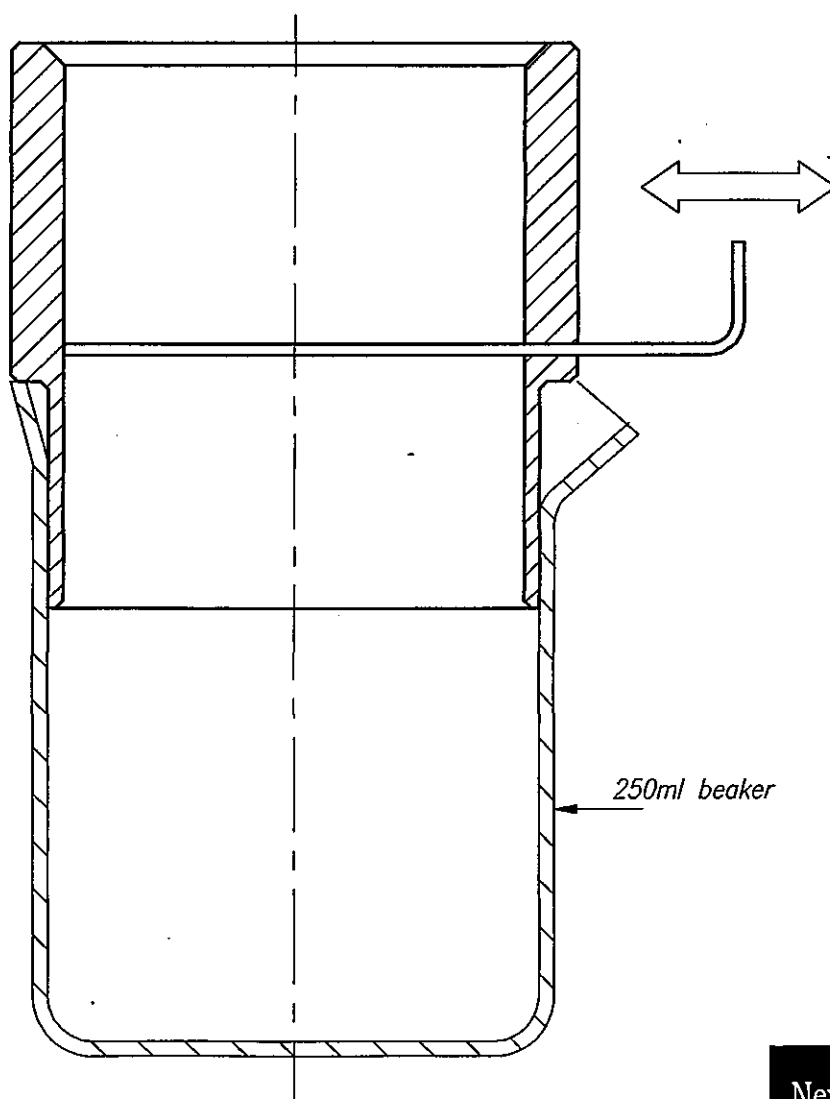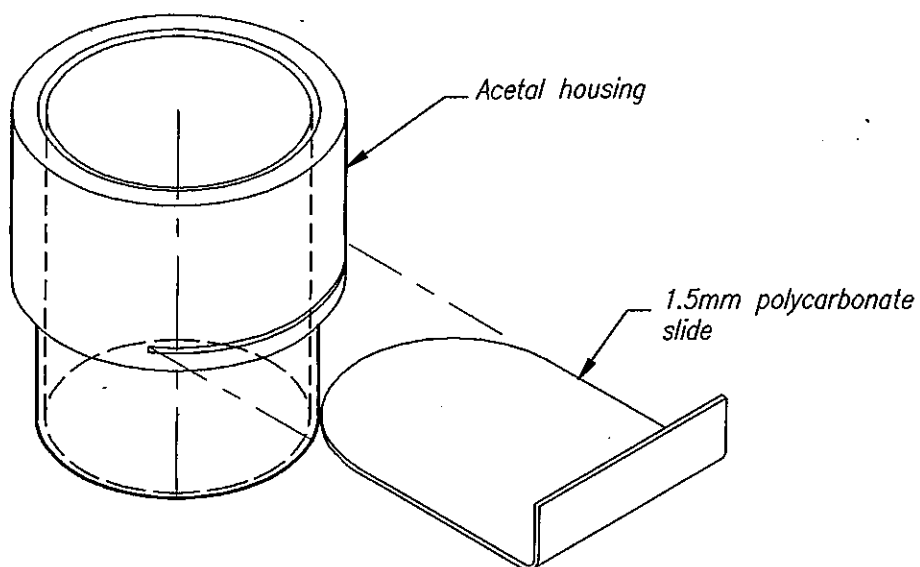

Drawing Title

Milk powder mixing slide valve

Drawn

IWH

Date

7-3-96

Scale

1:1

Drawing No

L2-438.1

New Zealand
Dairy Research
Institute